





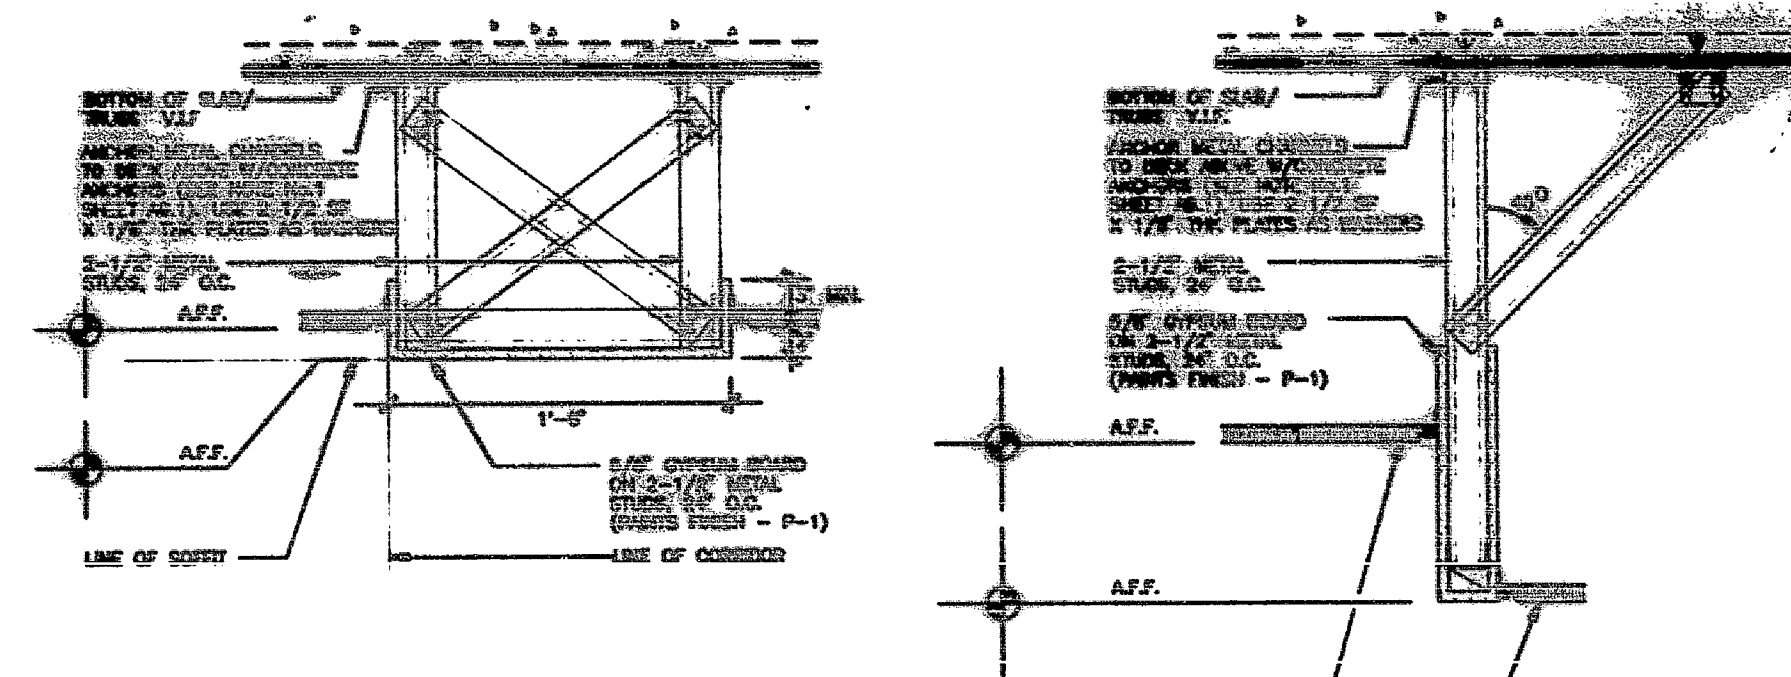


TAA # 941154
5/1/95

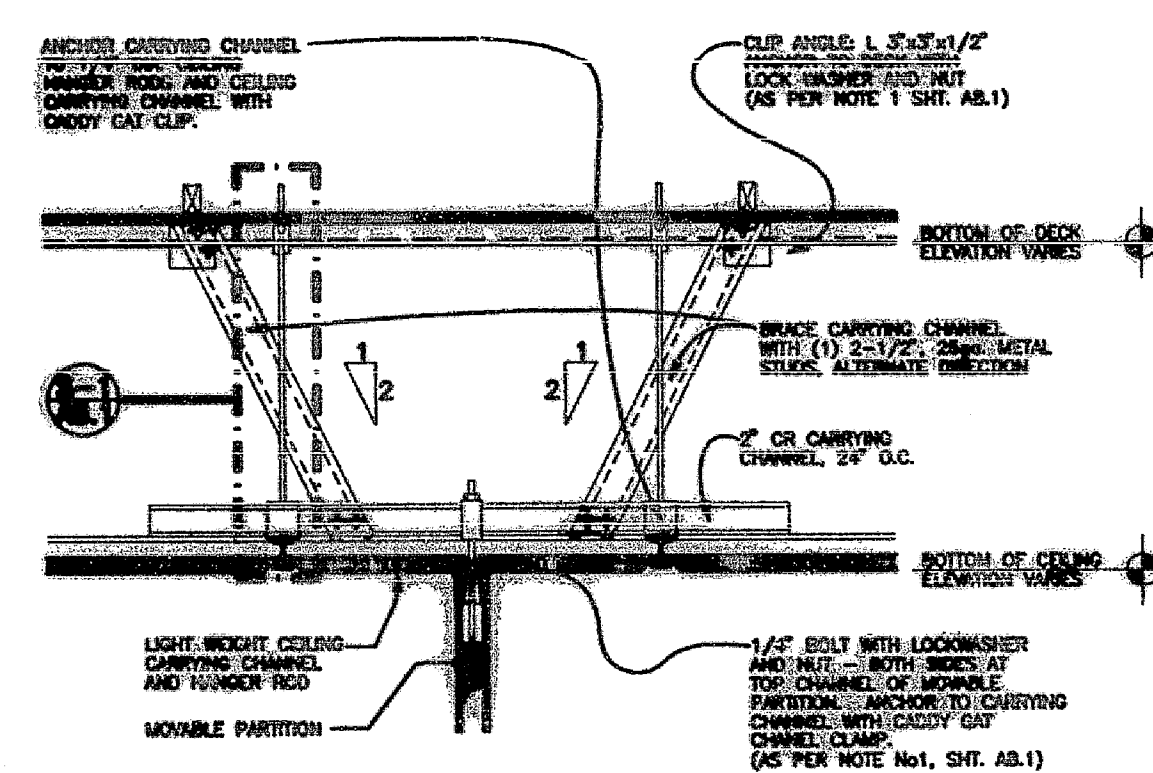


② DETAIL • CHANGE IN CLG.HT.
SCALE: 1"=1'-0"

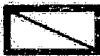


4 BRACING FOR DEMOUNTABLE PARTITIONS

- 2'x2' ACOUSTIC CEILING
TILE (SEE FISH
SCHEDULE A6.0)
- 
- SUSPENDED INDIRECT
LIGHTING -
LEDALITE BEAM 1
2 LAMP 18, 277V;
- WALL SCONCE -
VISA LIGHTING COLONNADE
CB3550 - 8A WALLMOUNTED
277V, 1-27W FLUORESCENT
-  SURFACE MOUNTED
CEILING FIXTURE -
LOUIS POULSER AJF-809
120V, NPF 2/13W/CF
-  RECESSED FLUORESCENT
LIGHTING -
2'x4' SLAMP, 18 CELL
PARABOLIC ENERGY EFFICIENT
FLUORESCENT FIXTURE
-  RECESSED FLUORESCENT
LIGHTING -
1'x4' LAMP, 6 CELL
PARABOLIC ENERGY EFFICIENT
FLUORESCENT FIXTURE
-  RECESSED FLUORESCENT
LIGHTING -
2'x2' SLAMP, 9 CELL
PARABOLIC

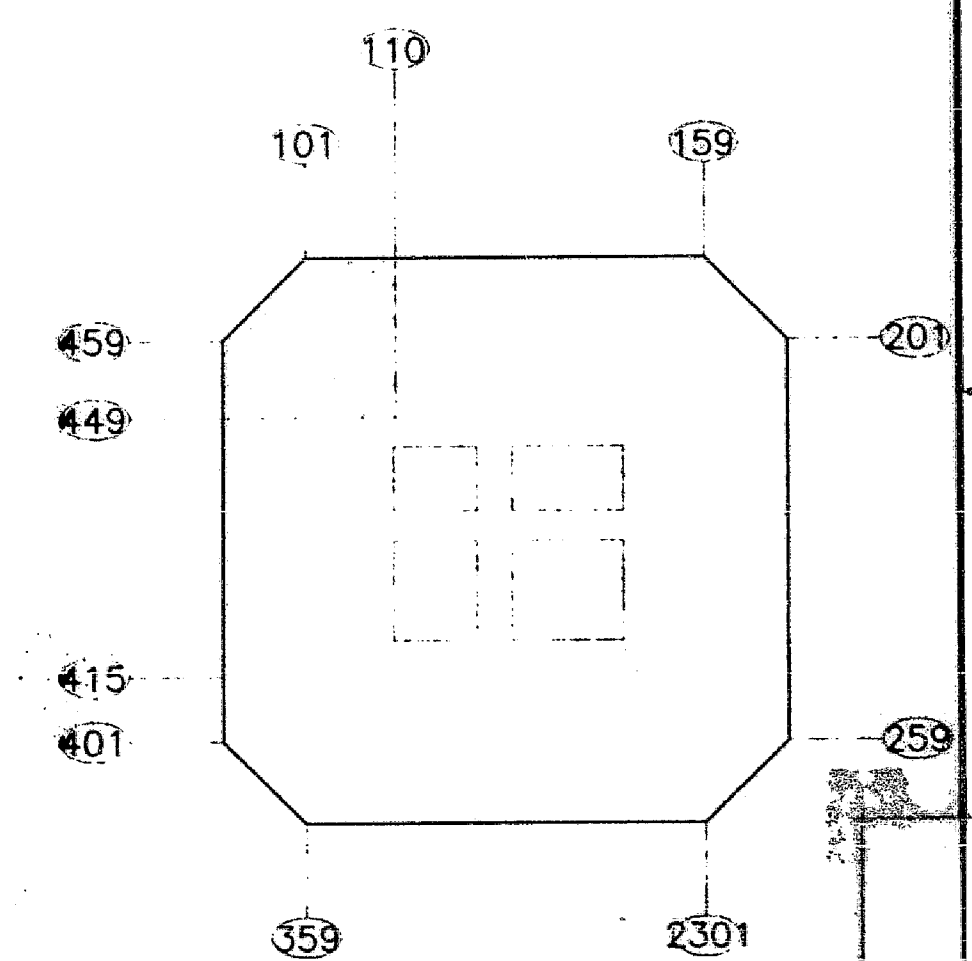

AREA OF WORK
NEW PLAN
ONE WORLD TRADE CENTER

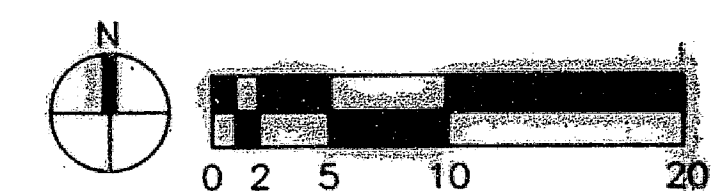

WEG DESIGN GROUP
ARCHITECTS • INTERIOR DESIGNERS
60 JOHN STREET, 19th Floor
New York, New York 10038
TEL: 212.506.5646
FAX: 212.506.5634


Dya Asanovich
NTX Interiors Inc.
General Contractor
Certified As-Built

No.	Revision	Included Record
1	11.14.94	REVISED AS PER PORT AUTHORITY COMMENTS SECOND SUBMISSION
2	136.95	REVISED AS PER PORT AUTHORITY COMMENTS THIRD SUBMISSION
	5.1.95	"AS-BUILT"

**REFLECTED
CEILING PLAN**

TAA 041154

Scale 1/8"=1'-0"	Drawn By JP/HR/MH
Project No. 94160	Date 10.10.94
	Desg. No.

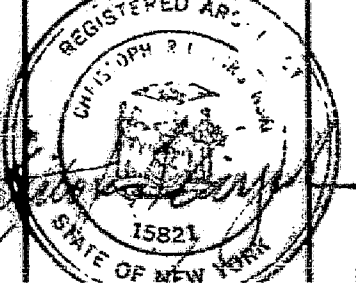

A4.1
FLOOR 10

Path: c:\program files\pinnacle\pinnacle 2.0\